

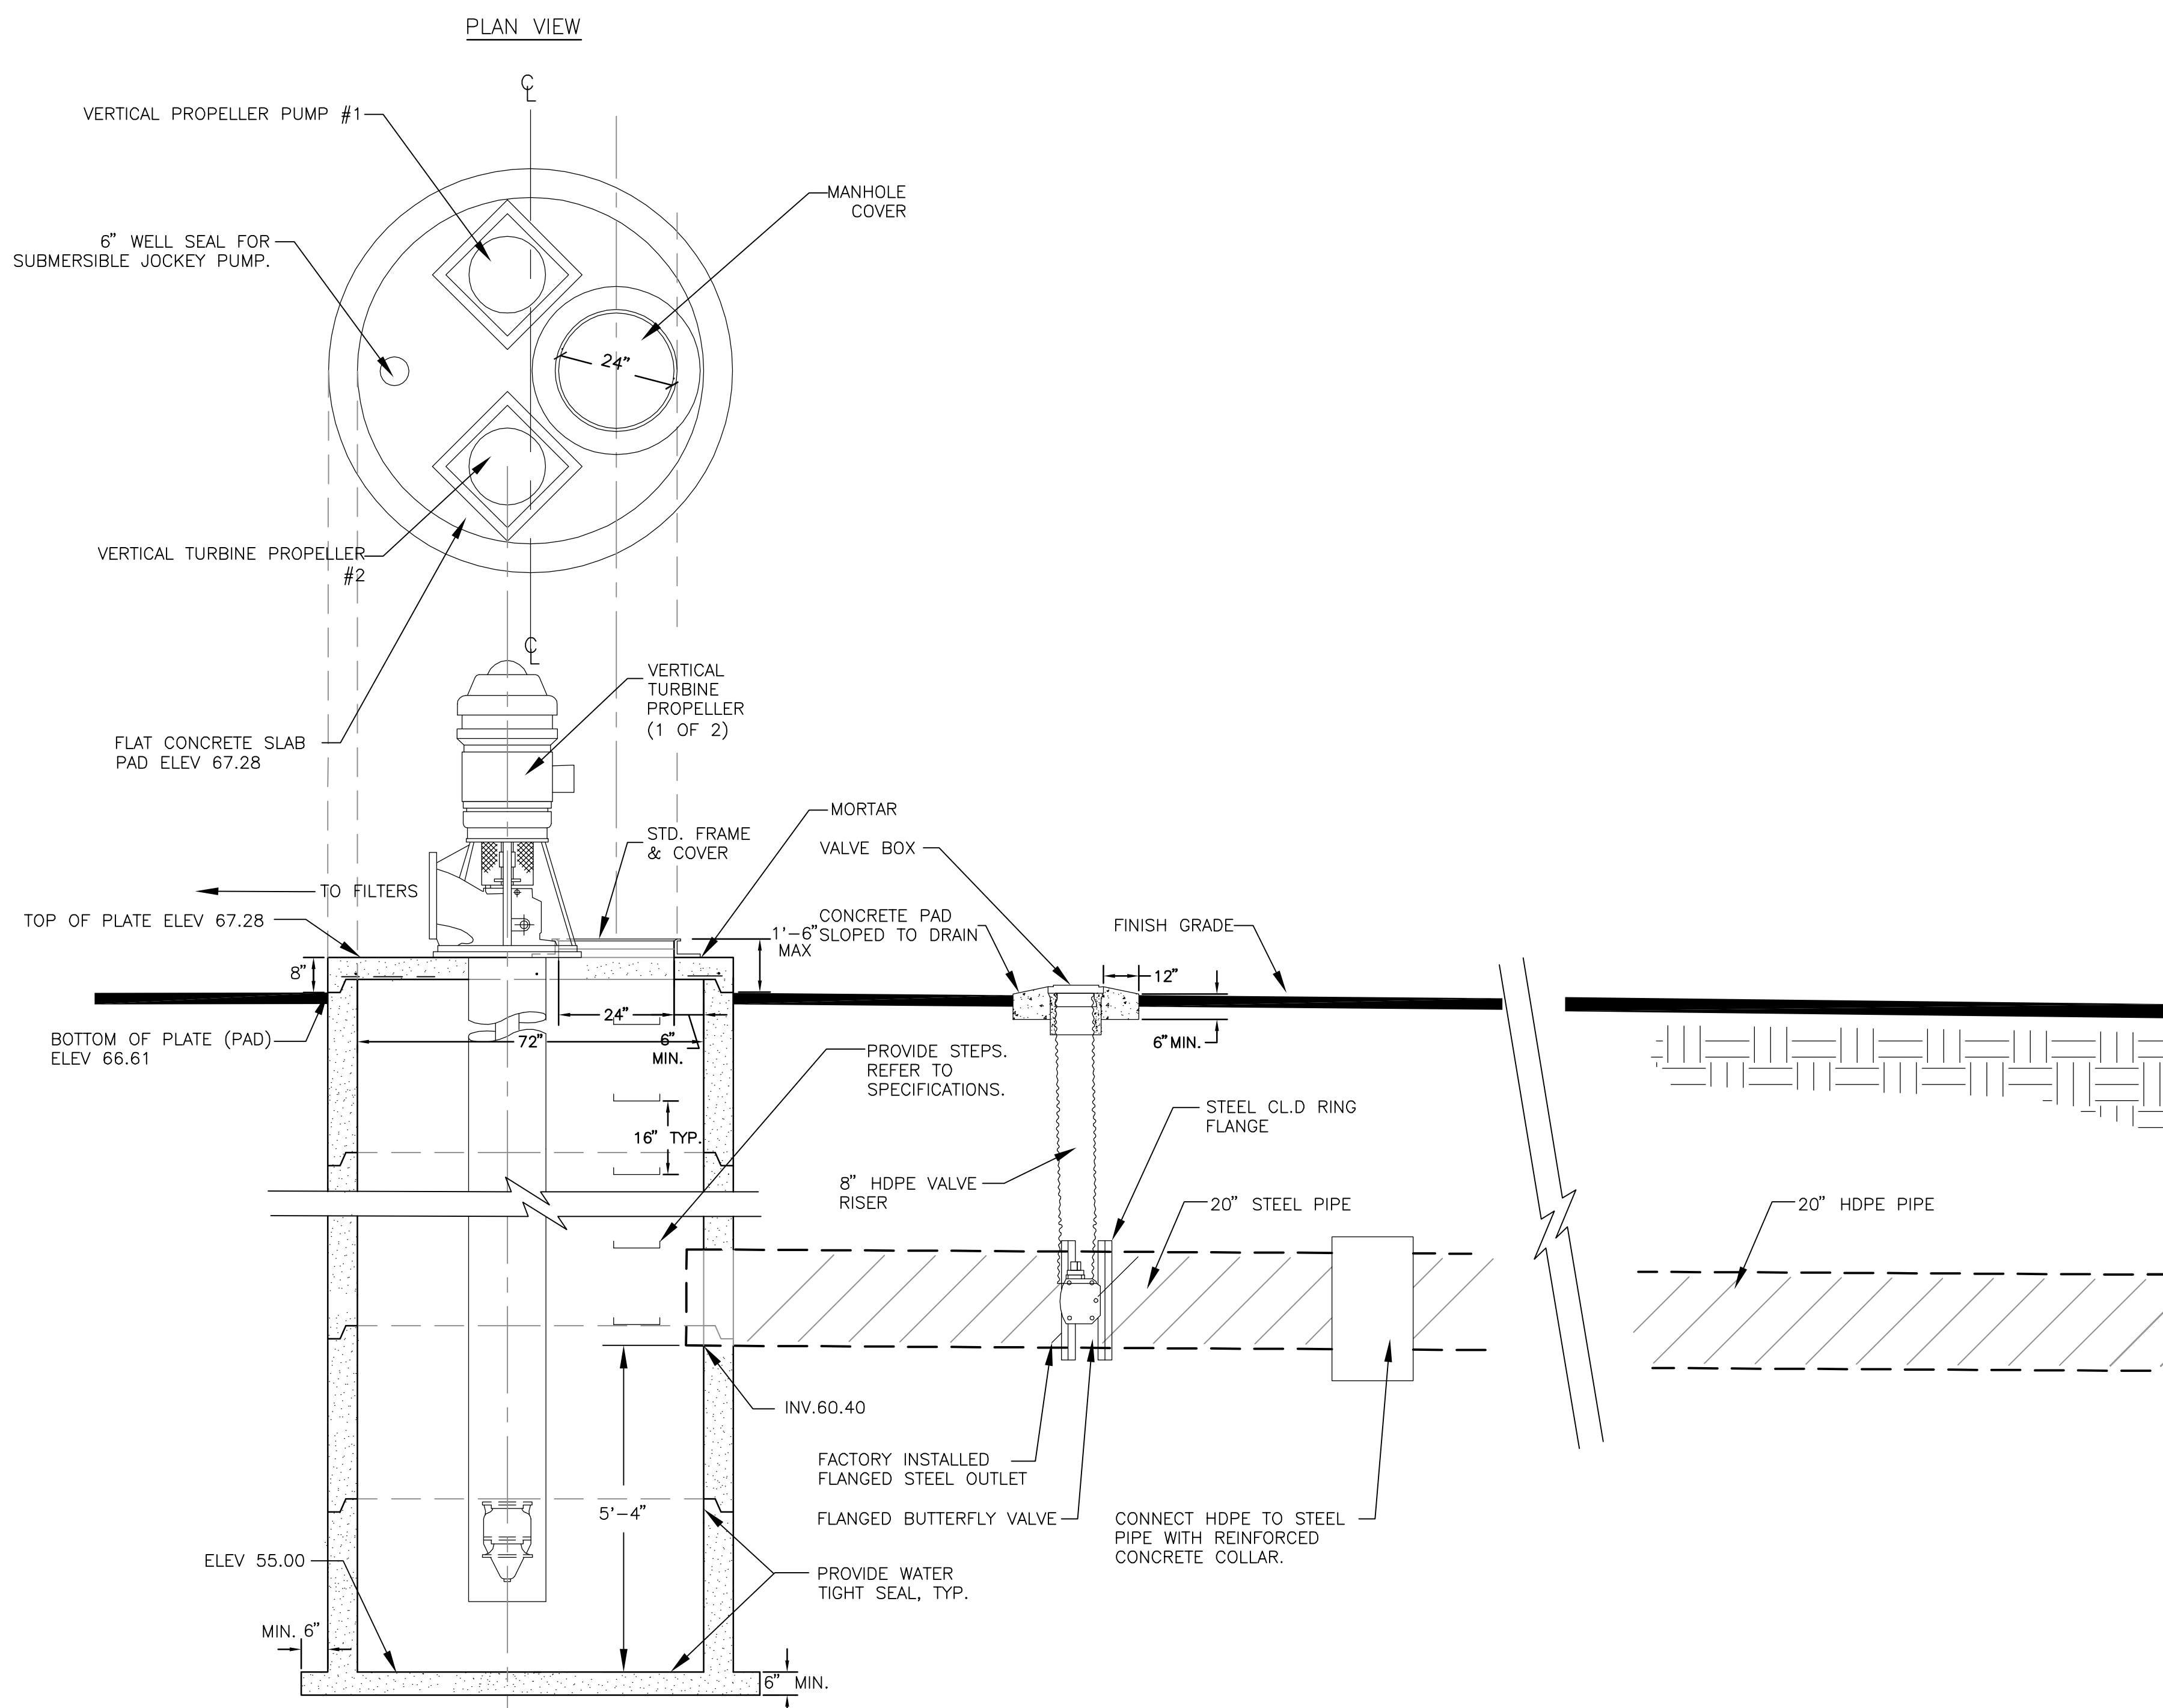


**B1** IRRIGATION POND UPTAKE TO PUMP/SUMP  
SCALE: 1/8" = 1'-0"

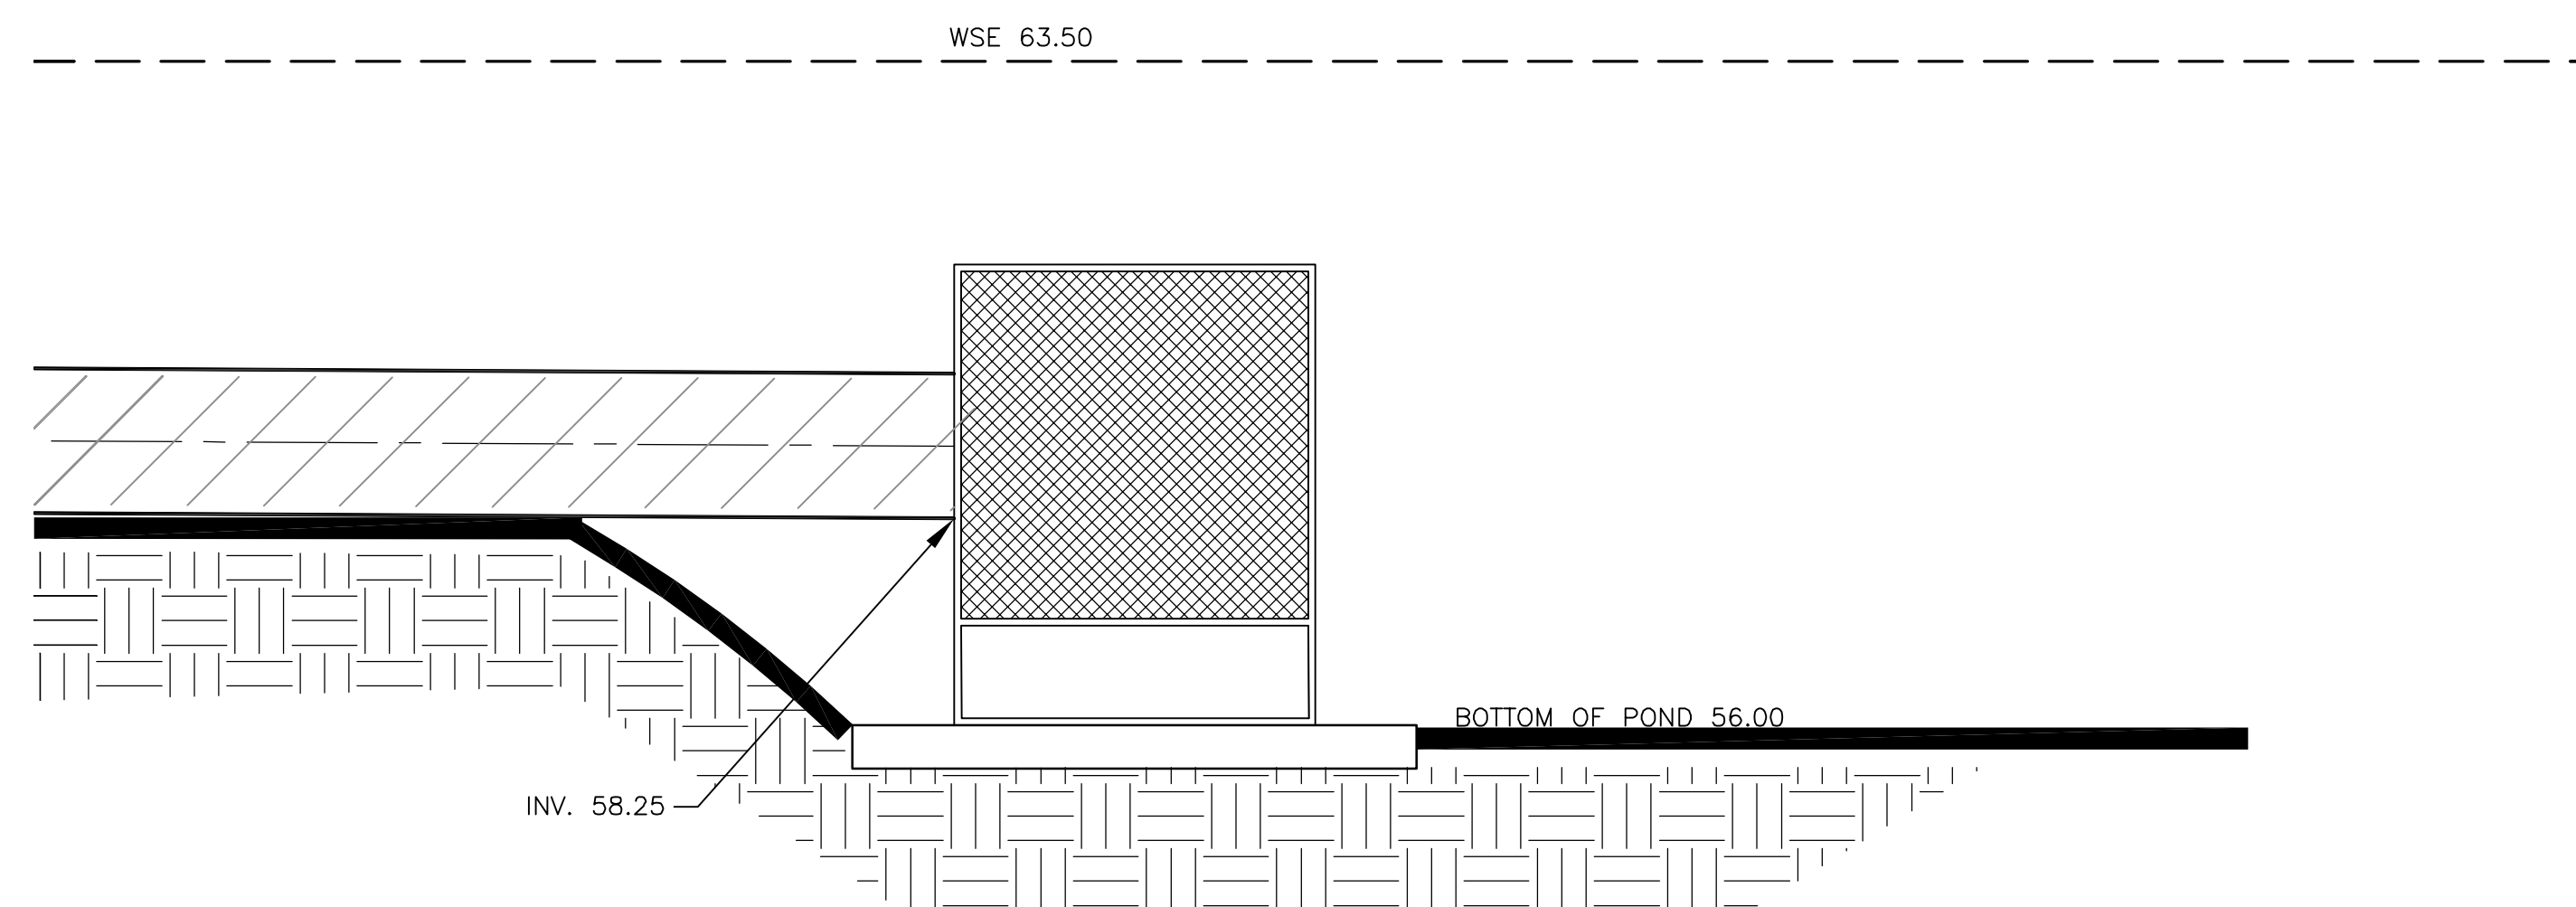

**F1** PUMP/SUMP IN PUMP STATION  
SCALE: 1/2" = 1'-0"

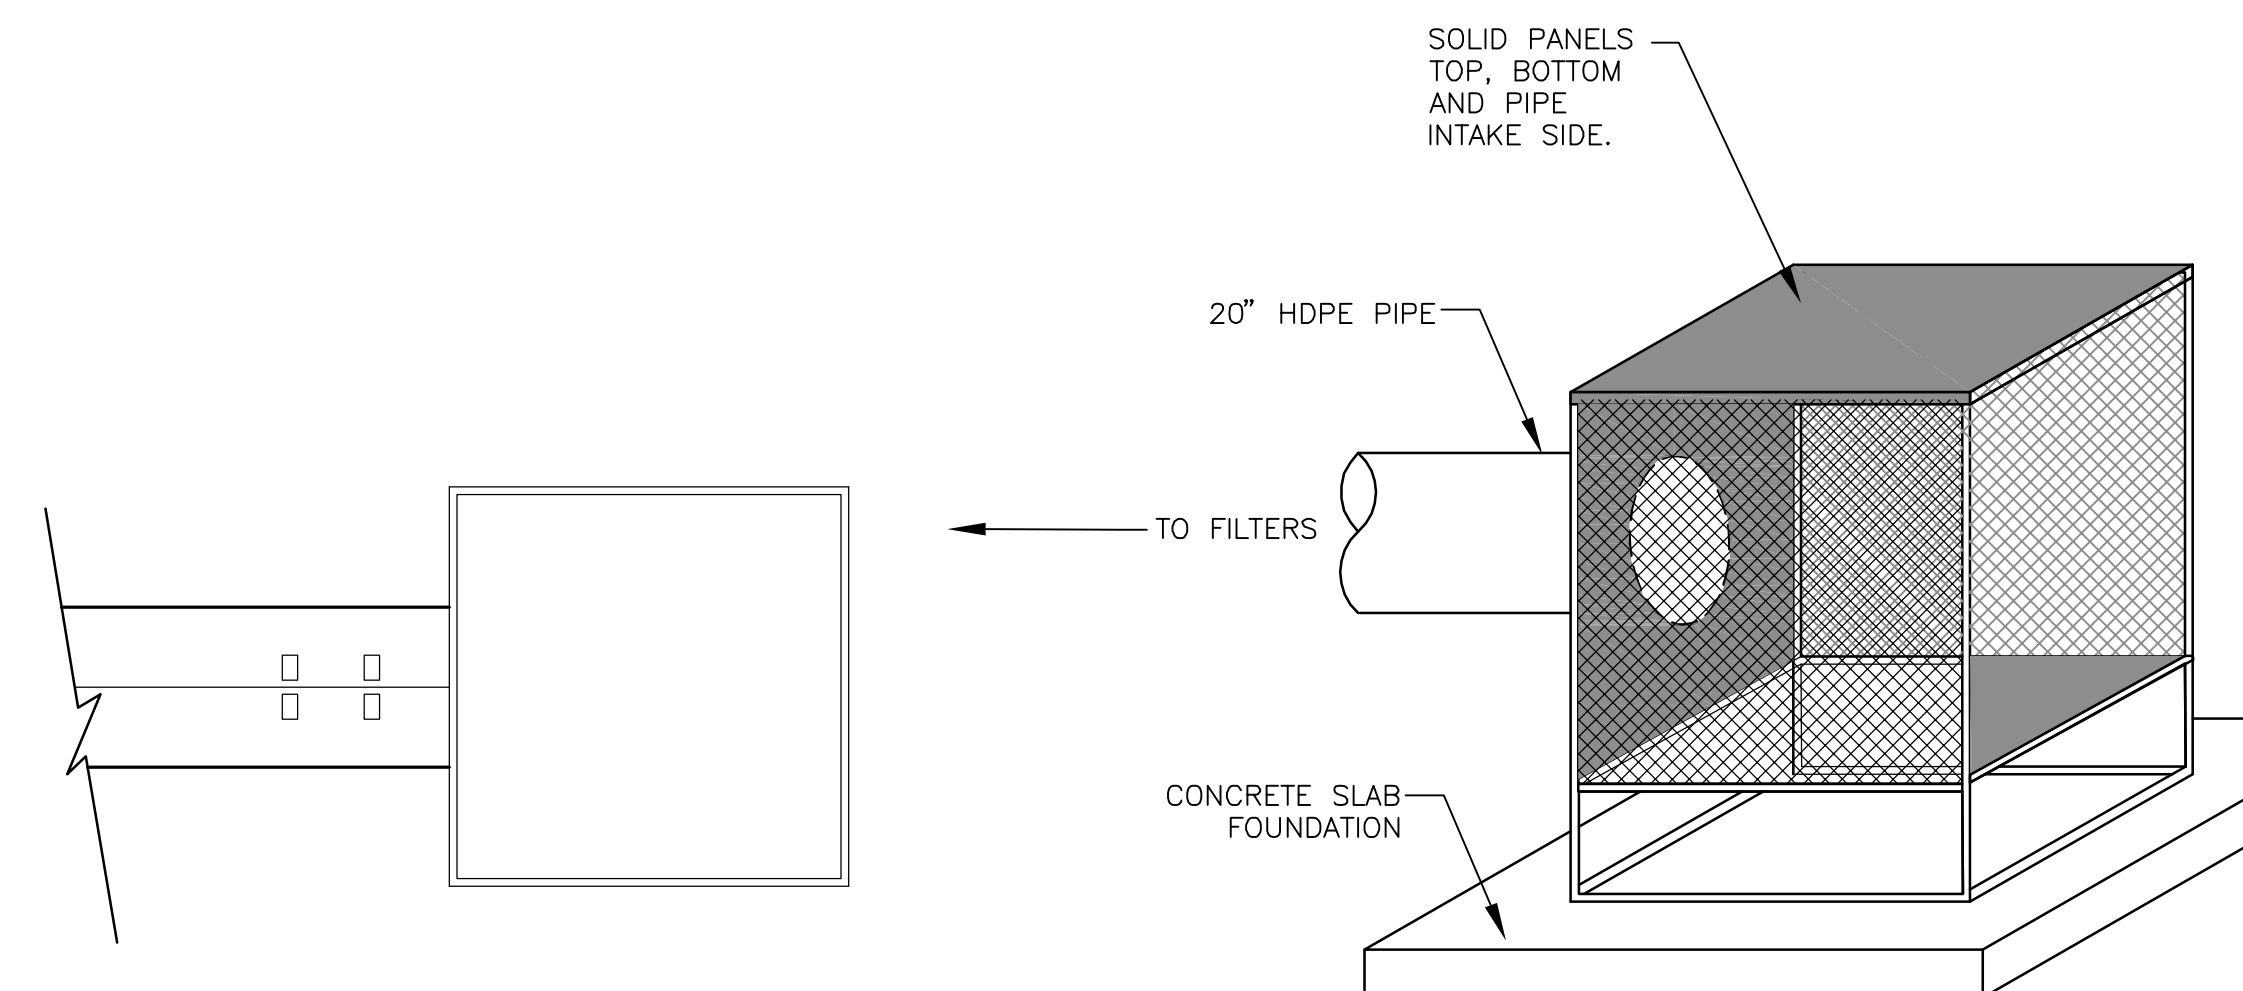

**F6** POND INTAKE SCREEN BOX  
SCALE: 1/2" = 1'-0"

AS - BUILT DRAWINGS

	MARCH 2010
Revisions	Date

AS-BUILT DRAWINGS  
PREPARED FROM AS-BUILT DRAWINGS  
PROVIDED BY CLARK & SULLIVAN,  
FEBRUARY, 2010. INFORMATION HAS NOT  
BEEN FIELD VERIFIED BY A/E.

**CarterBurgess**  
A Wholly Owned Subsidiary of Jacobs  
Consultants in Architecture, Engineering,  
Planning, and the Environment  
Sacramento Office  
180 Promenade Circle, Suite 300  
Sacramento, California 95834  
(916) 929-3323 Fax (916) 929-1772

Subconsultant List	
DREYFUSS & BLACKFORD	3540 FOLSOM BLVD., SACRAMENTO, CA. 95816 (916) 453-1234
CAPITAL ENGINEERING CONSULTANTS	11020 SUN CENTER DR., STE. 100 RANCHO CORDOVA, CA. 95670 (916) 851-3500
ECOM ENGINEERING CONSULTANTS	1796 TRIBUTE RD., SUITE 100, SACRAMENTO, CA. 95815 (916) 641-5600
BUEHLER & BUEHLER ASSOCIATES	600 Q STREET, STE. 200, SACRAMENTO, CA. 95814 (916) 443-0303
THE SIERRA WEST GROUP, LLC	2730 GATEWAY OAKS DRIVE, STE. 110 SACRAMENTO, CA. 95833 (916) 925-4000
MARCUS H. BOLE & ASSOCIATES	104 BLOCK DR. WHEATLAND, CA. 95692 (530) 633-0117
PAR ENVIRONMENTAL	1906 21ST STREET, SACRAMENTO, CA. 95816 (916) 739-8356
ESPANA GEOTECH CONSULTING (FUGRO)	502 GIUSEPPE CT., ROSEVILLE, CA. 95678 (916) 773-2600
PERRY DESIGN	2091 HIDDEN GOLD TRAIL, COOL, CA 95614 (530) 823-2621



N ATIONAL  
C EMETERY  
A DMINISTRATION

Drawing Title IRRIGATION DETAILS	
Approved: Director, Office of Construction Management	
Approved: Director, Project Management Service	

Project Title NEW NATIONAL CEMETERY PHASE IB DEVELOPMENT			Date: MARCH 2010
			Project No. 921CM2001B
Building Number	Checked JAT	Drawn WMR	DRAWING NO.  I-13  Dwg. 139 of 222
Location SACRAMENTO VALLEY VA NATIONAL CEMETERY SOLANO COUNTY, CALIFORNIA			